




C. Earl Hunter, Commissioner

Promoting and protecting the health of the public and the environment.

PUBLIC NOTICE AMENDMENT REQUEST

The permittee for P/N# **99-1G-281-P, Dean A Feltmann**, has requested an amendment to that issued permit. Specifically, the applicant proposes to keep a previously constructed 4' x 23'6" catwalk and a 30" x 23'6" catwalk, with handrails. The applicant also seeks to add a 3' x 3' x 8' storage locker on the existing pierhead. The proposed amendment is for modifications to a private recreational dock on and adjacent to the Wando River at Lot 20 (7 & 6) at end of 3rd Ave, Mount Pleasant, Charleston County, South Carolina.

Written comments will be received on this amendment request until March 17, 2008 at the address listed below. For further information please contact the project manager, James Trumbull, 843-953-0218.

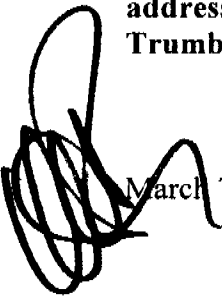

March 7, 2008

SOUTH CAROLINA DEPARTMENT OF HEALTH AND ENVIRONMENTAL CONTROL


Ocean and Coastal Resource Management

Charleston Office • 1362 McMillan Avenue, Suite 400 • Charleston, SC 29405

Phone: 843-953-0200 • Fax: 843-953-0201 • www.scdhec.gov

SC GRID

WATERS OF WANDO RIVER

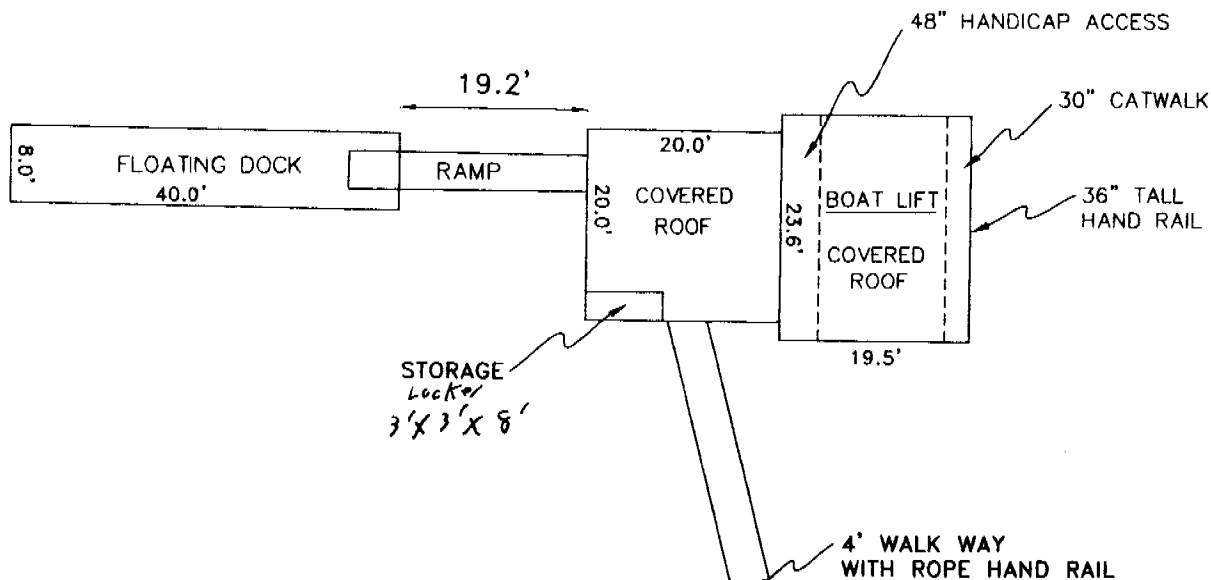


AS-BUILT
AS-BUILT DOCK SURVEY
SHOWING DOCK DIMENSIONS
PREPARED FOR:
DEAN A. FELTMAN
NOVEMBER 06, 2007
TOWN OF MT. PLEASANT
CHARLESTON COUNTY - SOUTH CAROLINA

SCALE: 1" = 20'



99-16-281-P

APPLICANT:	DEAN A. FELTMAN
ADDRESS	3RD STREET
SUBDIVISION	SCANLONVILLE
TAX MAP #	514-05-00-019
WATERBODY	WANDO RIVER
COUNTY/STATE	CHARLESTON, S.C.

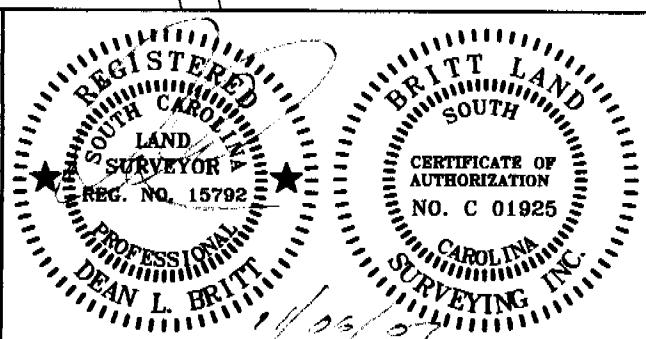

(Amendment Request for catwalks & storage bench